


Ground Floor
Control Point

- NOTES**
1. Levels : Local Datum.
 2. Grid : Local Grid.
 3. North Point indicative only.
 4. Drainage pipe sizes are approximate as gauged from the surface.
 5. Expert identification is advised for tree species.
 6. Boundary detail may not represent the extent of legally conveyed ownership.
 7. Survey carried out to client specification and in accordance with RICS publication: SURVEYS OF LAND, BUILDINGS & UTILITY SERVICES AT SCALES 1:500 & LARGER, 3rd EDITION.
 8. Copyright of this survey, and all associated drawings and digital information, is owned by Bury Associates Limited. This information may not be sold on to a third party without prior permission of Bury Associates Limited and payment of the appropriate fee.
 9. Internal door heights are evaluated on site, and are to be assumed as approximately 2.00m unless otherwise specified.

Websharecloud
With your survey we have provided a link which you can view your laser scanned building online.
The Webshare allows you to go room to room viewing the building as surveyed. Take measurements, make mark ups and create ortho images.
[113 - 115 High Street Websharecloud Link](#)

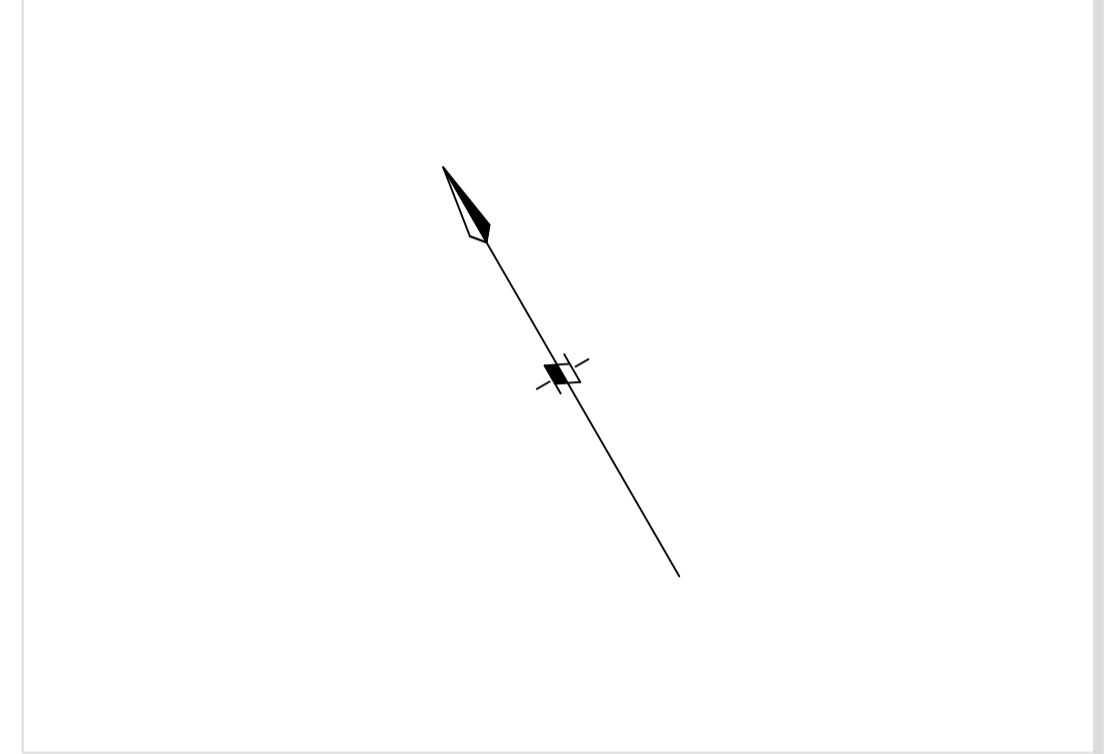

KEY

INTERNAL FEATURES	← C SLOPING CEILING (ARROW POINTS UP)
B BEAM HEIGHT	← B SLOPING BEAM (ARROW POINTS UP)
C CEILING HEIGHT	← DS SLOPING BEAM (ARROW POINTS UP)
D DOOR HEIGHT	← FL SLOPING FLOOR (ARROW POINTS UP)
DS DOOR SILL HEIGHT	← UP STEP UP (ARROW POINTS UP)
DH DOOR HEAD HEIGHT	← SP SPRING HEIGHT
FC FALSE CEILING	⬤ LIGHT SWITCH
FL FLOOR LEVEL	⬤ ELECTRICAL SOCKET
H HEAD HEIGHT	⬤ FIRE ALARM
S SILL HEIGHT	⬤ LIGHT
SP SPRING HEIGHT	⬤ TELEPHONE SOCKET
⬤ LIGHT SWITCH	⬤ FIRE ALARM
⬤ ELECTRICAL SOCKET	⬤ LIGHT
⬤ TV SOCKET	⬤ BOILER
⬤ IMMERSION HEATER	⬤ RAFTER
⬤ RADIATOR	

b **BURY ASSOCIATES**
DIGITISING YOUR WORLD
T: 01905 622495
surveys@buryassociates.co.uk
www.buryassociates.co.uk

Suite 4 Cadbury House,
Blackpole East,
Worcester, WR3 8SG



CLIENT **Troy Kidsley Architecture Ltd** 13 New Road
Bromsgrove
B60 2JG

PROJECT **113 - 115 High Street
Bromsgrove
B61 8AE**

DRAWING TITLE **Floor Plans
Ground Floor**

SCALE **1:100** SHEET SIZE **A1** DATE **06/08/20**

DRAWING NO. **BA30990720_02** SURVEYOR **IW**
DRAWN BY **IW**